


**MEMAR**  
CONSULTANTS INC.

0 2 5 10Feet






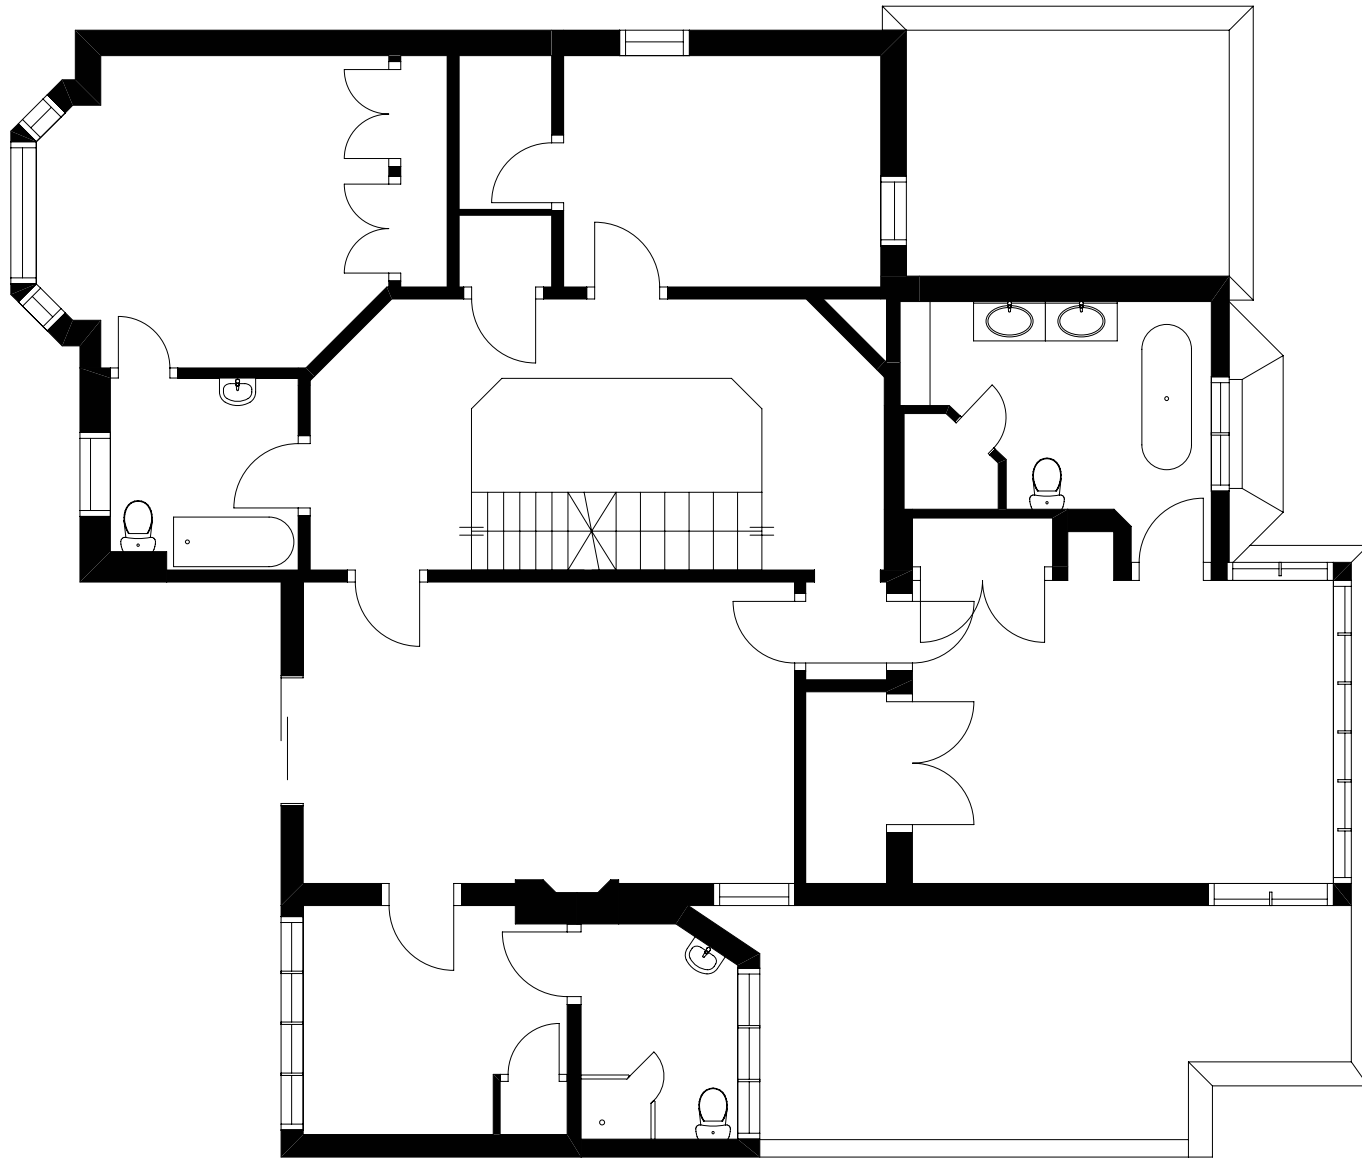

**MEMAR**  
CONSULTANTS INC.

0 2 5 10Feet



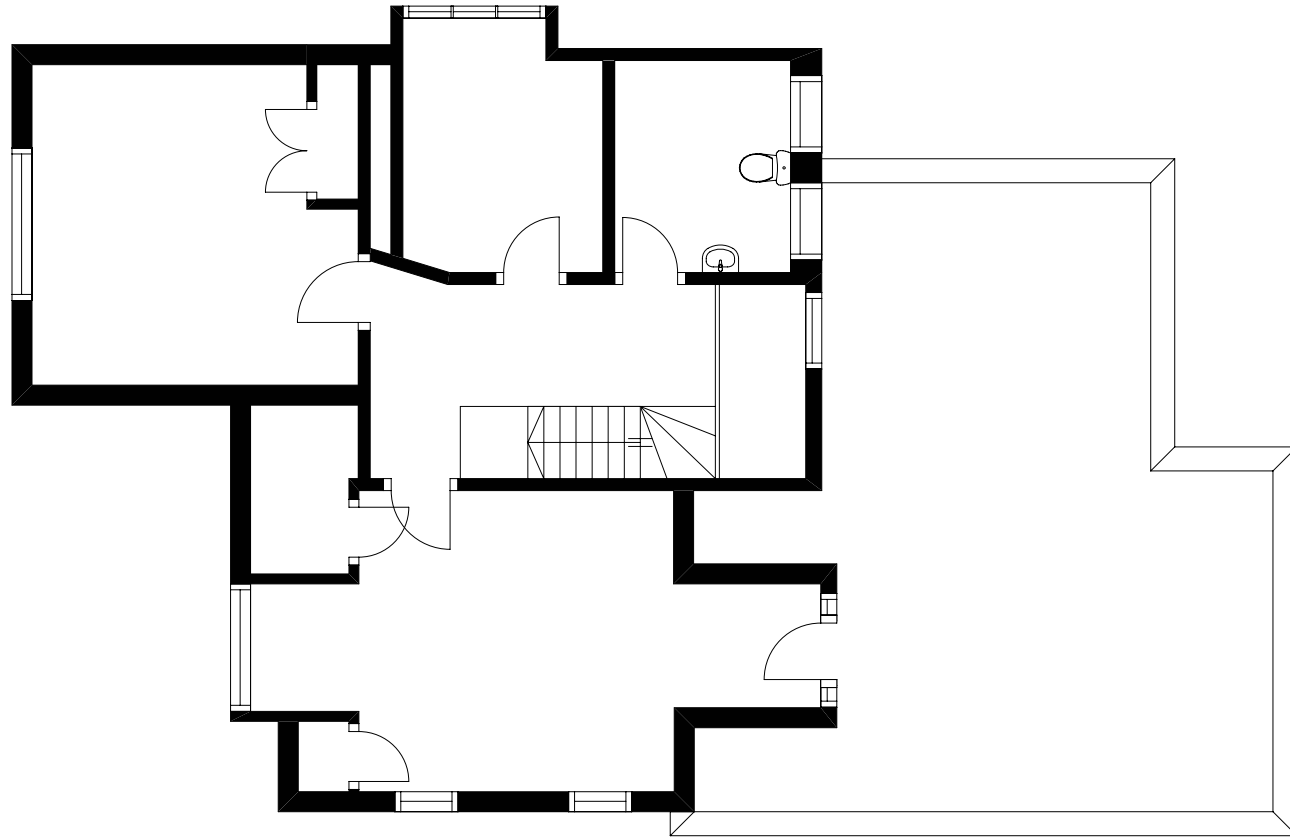

This Product is Prepared by  
 "Memar Consultants Inc."  
 Using Laser Technology  
 T:1-877-776-7639  
<http://www.MemarConsultants.com>

0 2 5 10Feet

3/18/2008

Revision:  
1.0

**Address:**

Project Address



Your Company Info



**East Elevation**



This Product is Prepared by  
 "Memar Consultants Inc."  
 Using Laser Technology  
 T:1-877-776-7639  
<http://www.MemarConsultants.com>



3/18/2008

Revision:  
1.0

**Address:**

Project Address



Your Company Info



**West Elevation**



This Product is Prepared by  
 "Memar Consultants Inc."  
 Using Laser Technology  
 T:1-877-776-7639  
<http://www.MemarConsultants.com>



3/18/2008


Revision:  
1.0

**Address:**

Project Address



Your Company Info

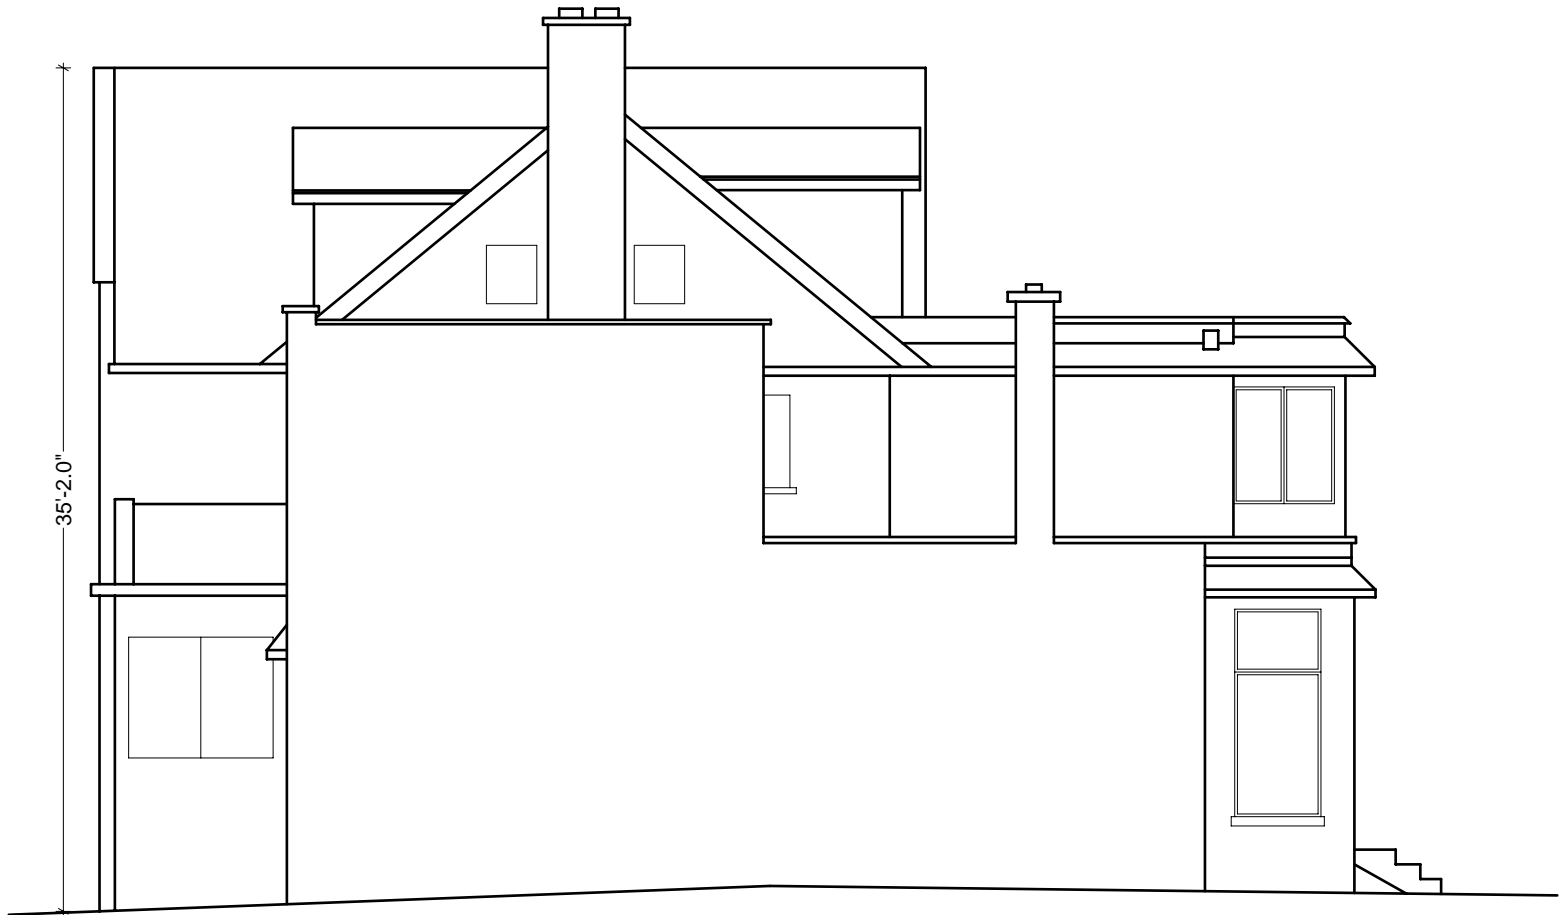

**South Elevation**



This Product is Prepared by  
 "Memar Consultants Inc."  
 Using Laser Technology  
 T:1-877-776-7639  
<http://www.MemarConsultants.com>



3/18/2008


Revision:  
1.0

**Address:**

Project Address



Your Company Info

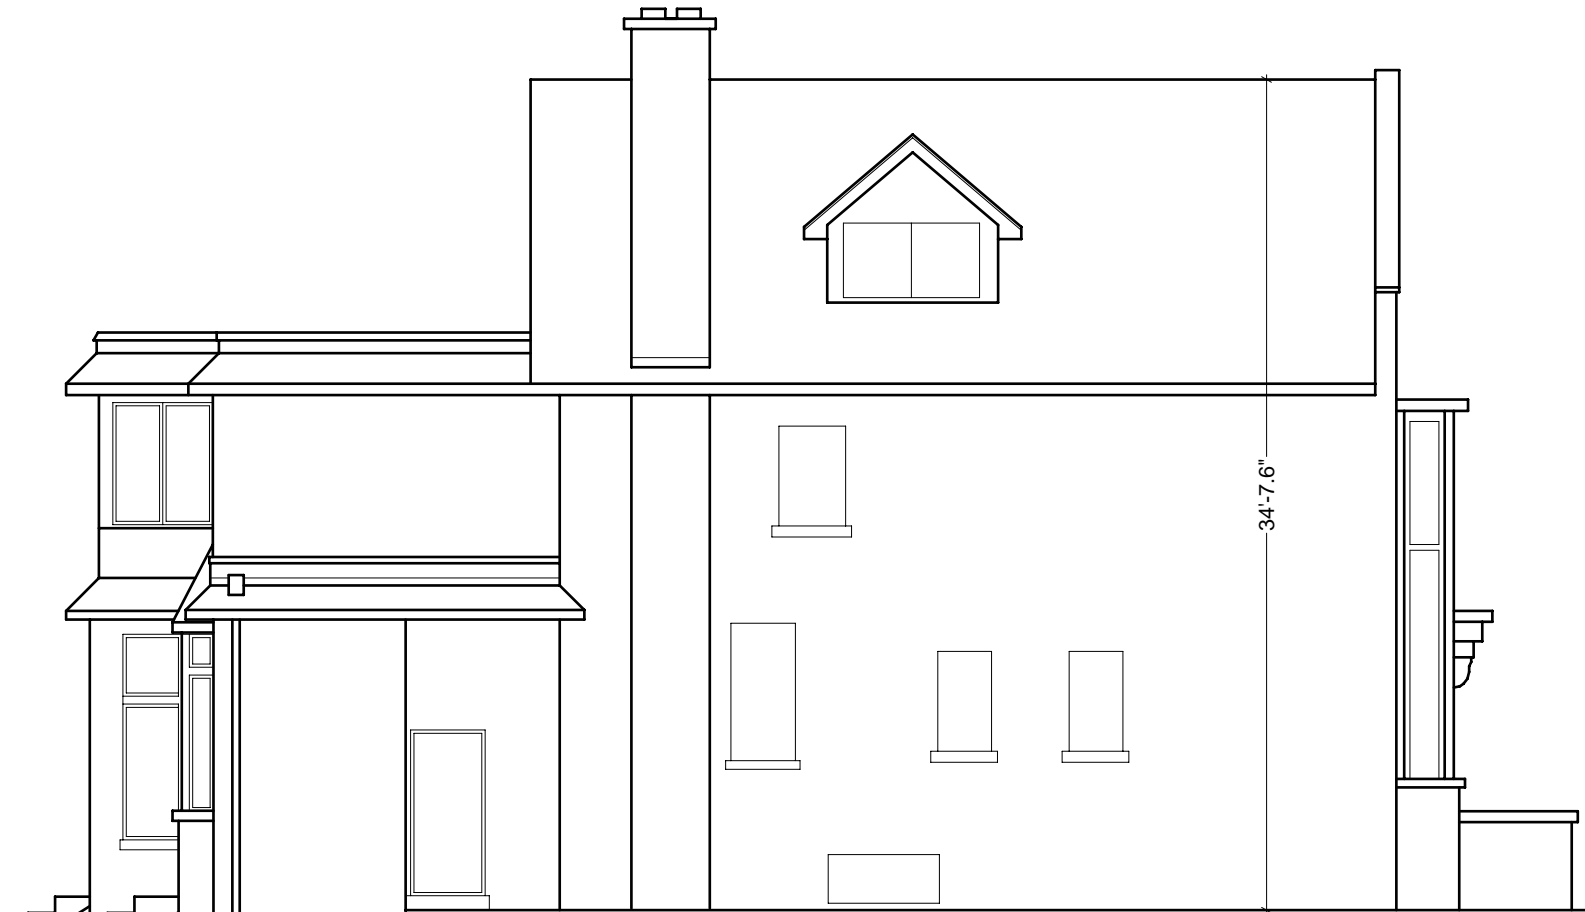

**North Elevation**



This Product is Prepared by  
 "Memar Consultants Inc."  
 Using Laser Technology  
 T:1-877-776-7639  
<http://www.MemarConsultants.com>



3/18/2008

Revision:  
1.0

**Address:**

Project Address



Your Company Info